

## **Environmental Information Regulations – Response - 27793**


*I am writing to request information concerning a fire hydrant located at Southbury, Rushbrooke Lane, Bury St Edmunds, Suffolk.*

*I have attached a current photograph showing both the yellow fire hydrant marker and the associated cover marked “FH”. The marker displays the figures 75 and 2.*

*I recently contacted Anglian Water seeking records relating to this hydrant. They have responded under the Environmental Information Regulations 2004 confirming that their mapping system does not show a fire hydrant outside my property and advising that information concerning fire hydrants may instead be held by Suffolk Fire and Rescue Service.*

*I would therefore be grateful if you could provide any records held by Suffolk Fire and Rescue Service or Suffolk County Council relating to this particular hydrant and marker, including, where held:*

*- the recorded location of the hydrant and marker, including any plan, map, coordinates or measurements identifying their position;*

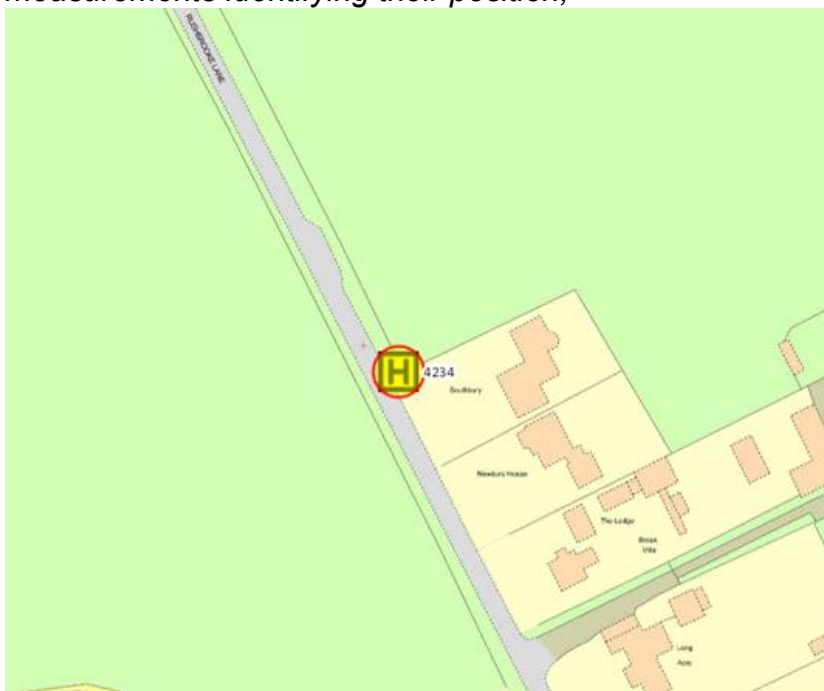

**E586778, N263162 (approx. co-ordinates)**

*- the date or approximate date the hydrant was installed;*

**We do not have the installation date on record.**

*- any historic records relating to its installation;*

**05/01/2004, 29/01/2010, 06/12/2012, 30/08/2017, 09/11/2020 & 21/07/2026**

- the identity of the authority, water undertaking or other body responsible for its installation;

**Anglian Water**

- any record identifying the land on which the hydrant and/or marker was installed;

**No record available**

- any record of the ownership or status of that land at the time of installation;

**No record available**

- any agreement, consent, licence, easement, wayleave or other permission relating to the installation, inspection, maintenance or continued presence of the hydrant or marker;

**No record available**

- any subsequent inspection, maintenance, relocation or replacement records which assist in identifying its historic or present location;

**Hydrant inspection dates; 05/01/2004, 29/01/2010, 06/12/2012, 30/08/2017, 09/11/2020 & 21/07/2026**

and

- the hydrant's reference or asset number and any associated asset record.

**FH/50414**

*For clarity, I am seeking the historic and current records relating to this specific hydrant and its location, rather than general information about fire hydrants.*