

modified order

WILDLIFE AND COUNTRYSIDE ACT 1981

DEFINITIVE MAP AND STATEMENT FOR THE PARISH OF NEWMARKET
IN THE DISTRICT OF FOREST HEATH

SUFFOLK COUNTY COUNCIL
(PARISH OF NEWMARKET) MODIFICATION ORDER 2018

This Order is made by Suffolk County Council under section 53(2)(b) of the Wildlife and Countryside Act 1981 ("the Act"), because it appears to that authority that the Definitive Map and Statement for the parish of Newmarket in the district of Forest Heath require modification in consequence of the occurrence of an event specified in sections 53(3)(c)(i) namely, the discovery by the authority of evidence which shows that a ~~footpath~~, which is not shown in the map and statement subsists or is reasonably alleged to subsist. *restricted by way*

The authority has consulted with every local authority whose area includes the land to which the Order relates. The Suffolk County Council hereby order that:

1. For the purpose of this Order the relevant date is 1 October 2018.
2. The Definitive Map and Statement for the parish of Newmarket in the district of Forest Heath shall be modified as described in Part I and Part II of the Schedule and shown on the map attached to the Order.
3. This Order shall take effect on the date it is confirmed and may be cited as the Suffolk County Council (Parish of Newmarket) Modification Order 2018.

Date: 25 OCTOBER 2018

THE COMMON SEAL of SUFFOLK
COUNTY COUNCIL was hereunto
affixed in the presence of:-



Bonnie Mylar

An authorised Officer of the Council

SCHEDULE

Part I: Modification of Definitive Map

Description of ~~footpath~~ ^{resinded by us} to be added

There shall be added to the Definitive Map for the parish of Newmarket a ~~footpath~~ ^{resinded by us} from a point at Ordnance Survey grid reference 56474,26295 to a point at Ordnance Survey grid reference 56472,26297 as shown on the attached map.

Part II: Modification of Definitive Statement

Particulars of ~~footpath~~ ^{resinded by us} to be added

There shall be added to the Definitive Statement for Newmarket the following particulars:

Newmarket ~~Footpath~~ ^{resinded by us} 30


Commencing at a junction with Cricket Field Road (Point A) at Ordnance Survey Grid Reference (OSGR) 56474,26295 and progressing in a north westerly direction along a path for 17 metres to a gate at OSGR 56472,26296; continuing across railway level crossing for 11 metres to a gate and a junction with Granary Road (Point B) at OSGR 56472,26297.

Width: ~~1.2 metres~~ ^{30 feet (9 metres)}

~~(Width is what has been made available and maintained on the ground).~~

~~Limitations: Pedestrian gates at OSGR 56472,26296 and OSGR 56472,26297~~

23657

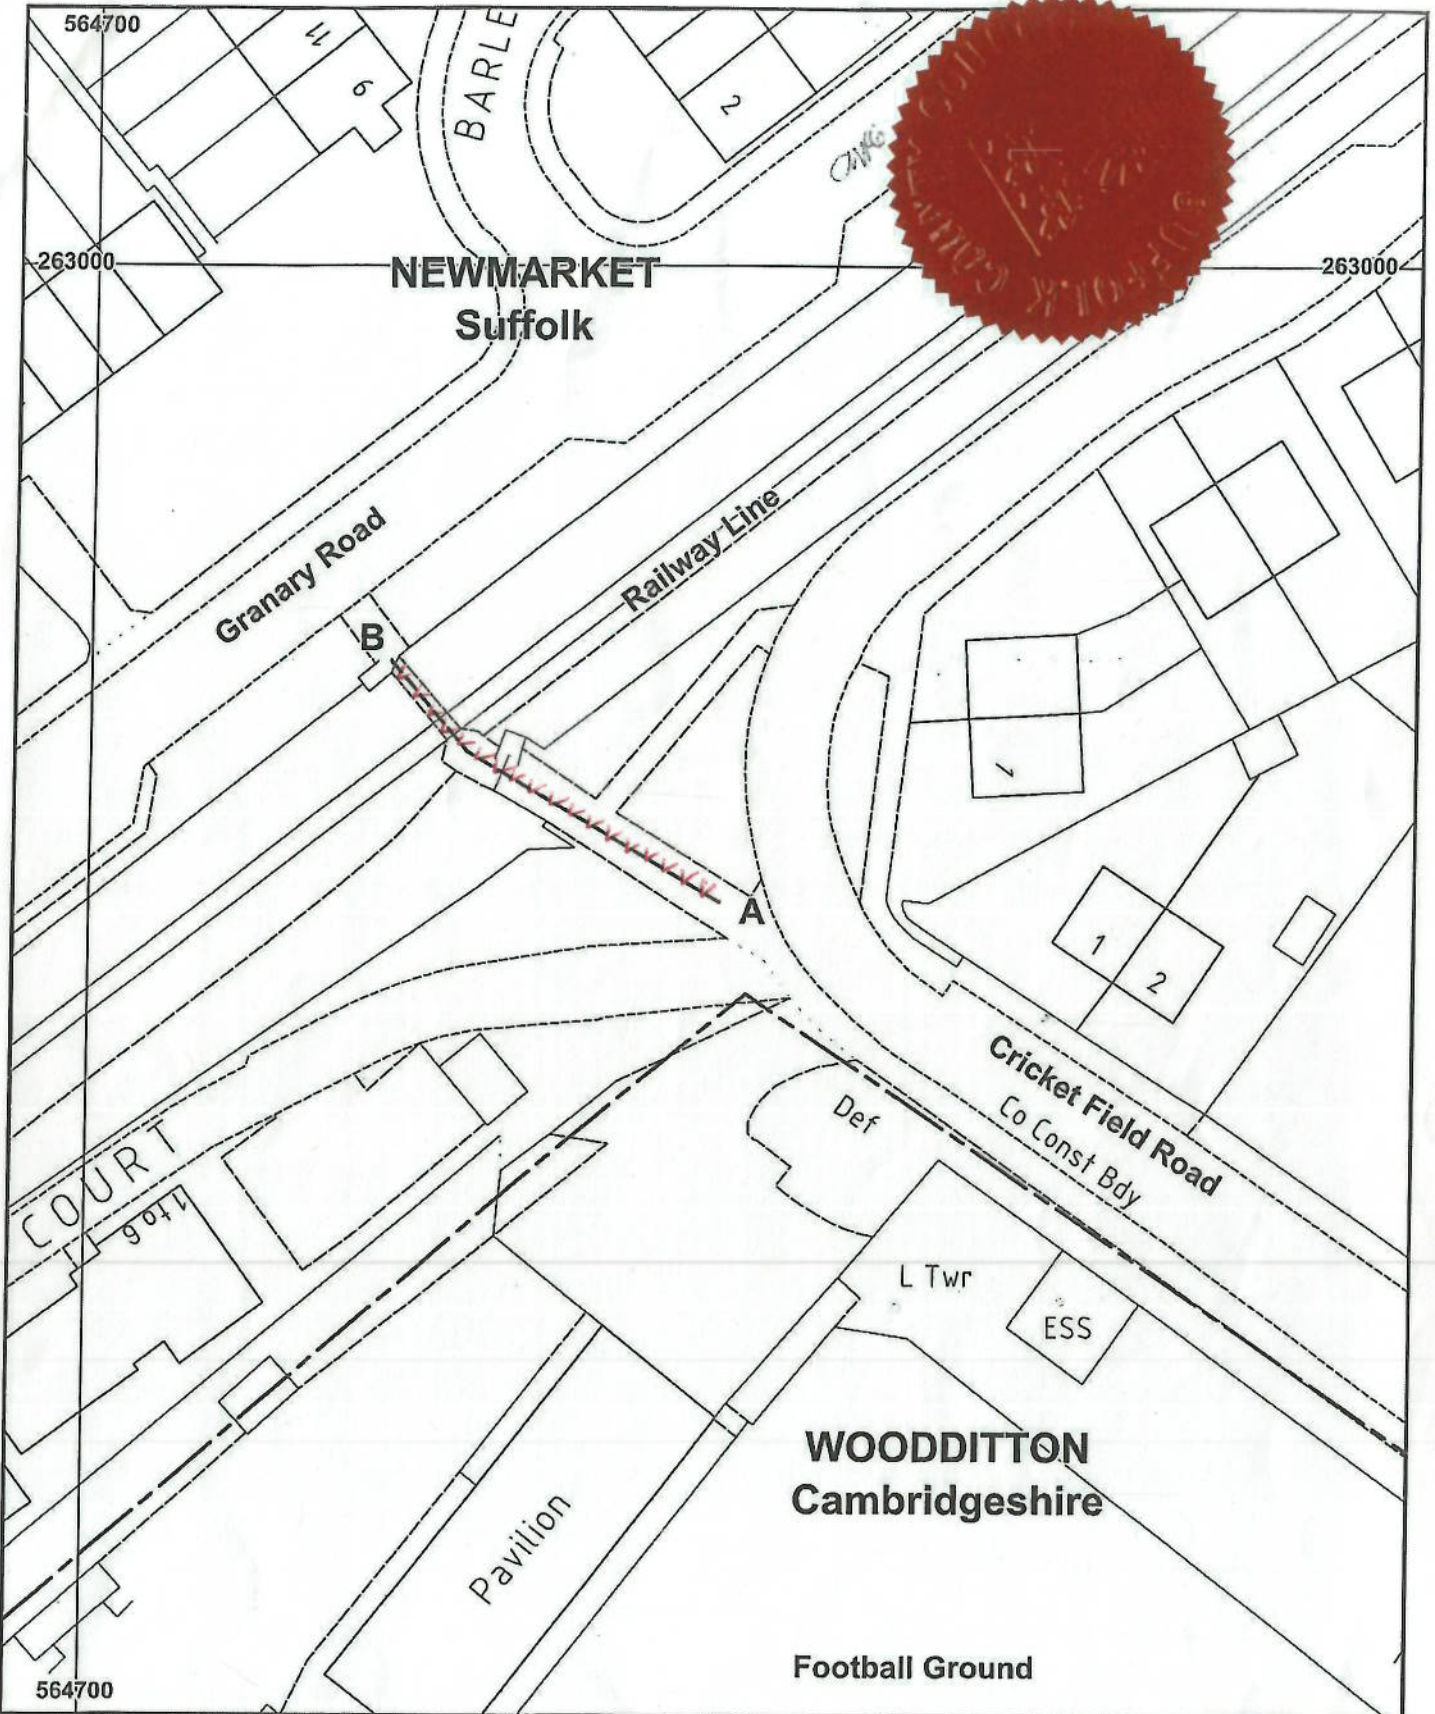

PROPOSED PUBLIC FOOTPATH - CRICKET FIELD RD TO GRANARY RD, NEWMARKET

Restricted Byes



Director of Growth, Highways and Infrastructure,
Endeavour House, 8 Russell Road, Ipswich, Suffolk. IP1 2BX



Proposed Public Footpath



Parish and County Boundary

Restricted Byes

Scale 1:500



Ordnance Survey MasterMap

Crown Copyright. All rights reserved.
Suffolk County Council Licence No. 100023395 2018

Filed at:

