

NOTICE OF CONFIRMATION OF MODIFICATION ORDER

SECTION 53 OF THE WILDLIFE & COUNTRYSIDE ACT 1981

DEFINITIVE MAP AND STATEMENT FOR THE FORMER RURAL DISTRICT OF THINGOE IN THE FORMER ADMINISTRATIVE COUNTY OF WEST SUFFOLK

SUFFOLK COUNTY COUNCIL (THINGOE RURAL DISTRICT DEFINITIVE MAP AND STATEMENT)(PARISH OF HEPWORTH) MODIFICATION ORDER 2017

On 28 January 2020 an Inspector appointed by the Secretary of State for Environment, Food and Rural Affairs confirmed the above-named order with modifications. The effect of the order as confirmed is to modify the definitive map and statement for the area by adding public footpaths crossing the fields between Beck Street and Wood Lane (Restricted Byway 8). One footpath runs from Beck Street west of Ivy Nook Farm at Ordnance Survey Grid Reference (OSGR) 59888,27599 in a generally south-westerly direction to Wood Lane (Restricted Byway 8) at OSGR 59866,27526. The second footpath starts on Beck Street west of Dormer Cottage at OSGR 59866,27604 and runs in a generally south-easterly direction to a junction with the other footpath at OSGR 59882,27574, as shown on the order map.

A copy of the order and of the map contained in it may be inspected free of charge at the offices of Suffolk County Council, Phoenix House, 3 Goddard Road, Ipswich, IP1 5NP between 9.00 and 17.00, Monday to Thursday and 9.00 to 16.00 on Friday, or purchased at a cost of £2. A copy of the order may be sent by post, if requested in writing, at a cost of £2.50.

A copy of the order may also be viewed at

<http://www.suffolkpublicrightsofway.org.uk/home/public-notice-about-legal-orders/>

or inspected free of charge at Stanton Post Office, Jasmine Cottage, The Street, Stanton, IP31 2BP. Opening times:

Mon, Tue, Thur, Fri	0900 - 1730
Wed	0900 - 1300
Sat	0900 - 1200
Sun	Closed

The order became operative on 28 January 2020 but if any person aggrieved by the order desires to question its validity or that of any provision contained in it on the grounds that it is not within the powers of Section 53 or that any of the requirements of Schedule 15 to the Wildlife and Countryside Act 1981 have not been complied with, they may within 42 days of the date of publication of this notice apply to the High Court.

Dated: 13 February 2020



Nigel Inniss
Head of Legal Services
Constantine House
5 Constantine Road
IPSWICH, IP1 2DH

The Rights of Way and Access Privacy Notice can be viewed at:

<https://www.suffolk.gov.uk/about/privacy-notice/rights-of-way-and-access-privacy-notice/>

WILDLIFE AND COUNTRYSIDE ACT 1981

DEFINITIVE MAP AND STATEMENT FOR THE FORMER RURAL DISTRICT OF THINGOE IN THE FORMER ADMINISTRATIVE COUNTY OF WEST SUFFOLK

SUFFOLK COUNTY COUNCIL (THINGOE RURAL DISTRICT DEFINITIVE MAP AND STATEMENT)(PARISH OF HEPWORTH) MODIFICATION ORDER 2017

This Order is made by Suffolk County Council under section 53(2)(b) of the Wildlife and Countryside Act 1981 ("the Act"), because it appears to that authority that the Definitive Map and Statement for the former Rural District of Thingoe in the former Administrative County of West Suffolk require modification in consequence of the occurrence of an event specified in section 53(3)(c)(i) namely, the discovery of evidence which shows that footpaths which are not shown in the map and statement subsist or are reasonably alleged to subsist.

The authority has consulted with every local authority whose area includes the land to which the Order relates. The Suffolk County Council hereby Order that:

1. For the purpose of this Order the relevant date is 1 February 2017.
2. The Definitive Map and Statement for the former Rural District of Thingoe in the former Administrative County of West Suffolk shall be modified as described in Part I and Part II of the Schedule and shown on the map attached to the Order.
3. This Order shall take effect on the date it is confirmed and may be cited as the Suffolk County Council (Thingoe Rural District Definitive Map and Statement)(Parish of Hepworth) Modification order 2017.

Date: 13 February 2017

THE COMMON SEAL of SUFFOLK

COUNTY COUNCIL was hereunto

affixed in the presence of:-



An authorised Officer of the Council

The foregoing order is hereby confirmed subject to the red ink modifications thereon

Barney Grimshaw 28 JAN 2020

An Inspector appointed by The Secretary of State for Environment, Food and Rural Affairs

SCHEDULE

Part I: Modification of Definitive Map

Description of footpaths to be added

There shall be added to the Definitive Map for the former Rural District of Thingoe in the parish of Hepworth two footpaths. The first from a point at Ordnance Survey grid reference 59892,27594 to a point at Ordnance Survey grid reference 59866,27526, and the second from a point at Ordnance Survey grid reference 59866,27604 to a point at Ordnance Survey grid reference 59882,27574, both as shown on the order map.

59888, 27599

Part II: Modification of Definitive Statement

Particulars of footpaths to be added

There shall be added to the Definitive Statement for the former Rural District of Thingoe the following particulars:

Hepworth Footpath 10

Commencing on the southern side of Beck Street (U6412) on the western side of Ivy Nook Farm at Ordnance Survey Grid Reference (OSGR) 59888, 27599 running along a track in a south-easterly direction for 69 metres to OSGR 59882, 27597 then
Commencing on a track south-east of Ivy Nook Farm at Ordnance Survey Grid Reference (OSGR) 59892,27594 and progressing in a south south-westerly direction and passing across fields for 222 metres to a junction with Hepworth footpath 11 at OSGR 59882,27574; changing to a south south-easterly direction and continuing across fields for 92 metres towards the north-western corner of Blue Bells Plantation to OSGR 59886,27565; changing to a south south-westerly direction and continuing across fields for 437 metres to a junction with Hepworth restricted byway 8 at OSGR 59866,27526.

Width: ~~Varying between a minimum of 1.5 metres and a maximum of 2 metres.~~ *throughout.*


~~As shown by double pecked lines on Ordnance Survey Map 1st edition 1883 Sheets 24/9 and 23/16, 1:2500 scale.~~

Hepworth Footpath 11

Commencing on the southern side of Beck Street (U6412) west of Dormer Cottage at OSGR 59866,27604 and progressing in a south south-easterly direction across a field for 102 metres to a drain at OSGR 59870,27594; crossing the drain and continuing across a field for 70 metres to enter the north-eastern corner of a field plot at OSGR 59874,27589; continuing on the western side of the boundary for 48 metres to a point at OSGR 59877,27585; continuing across a field for 124 metres to a junction with Hepworth footpath 10 at OSGR 59882,27574.

Width: ~~2 metres.~~

~~As shown by double pecked lines on Ordnance Survey Map 1st edition 1883 Sheets 24/9, 1:2500 scale.~~

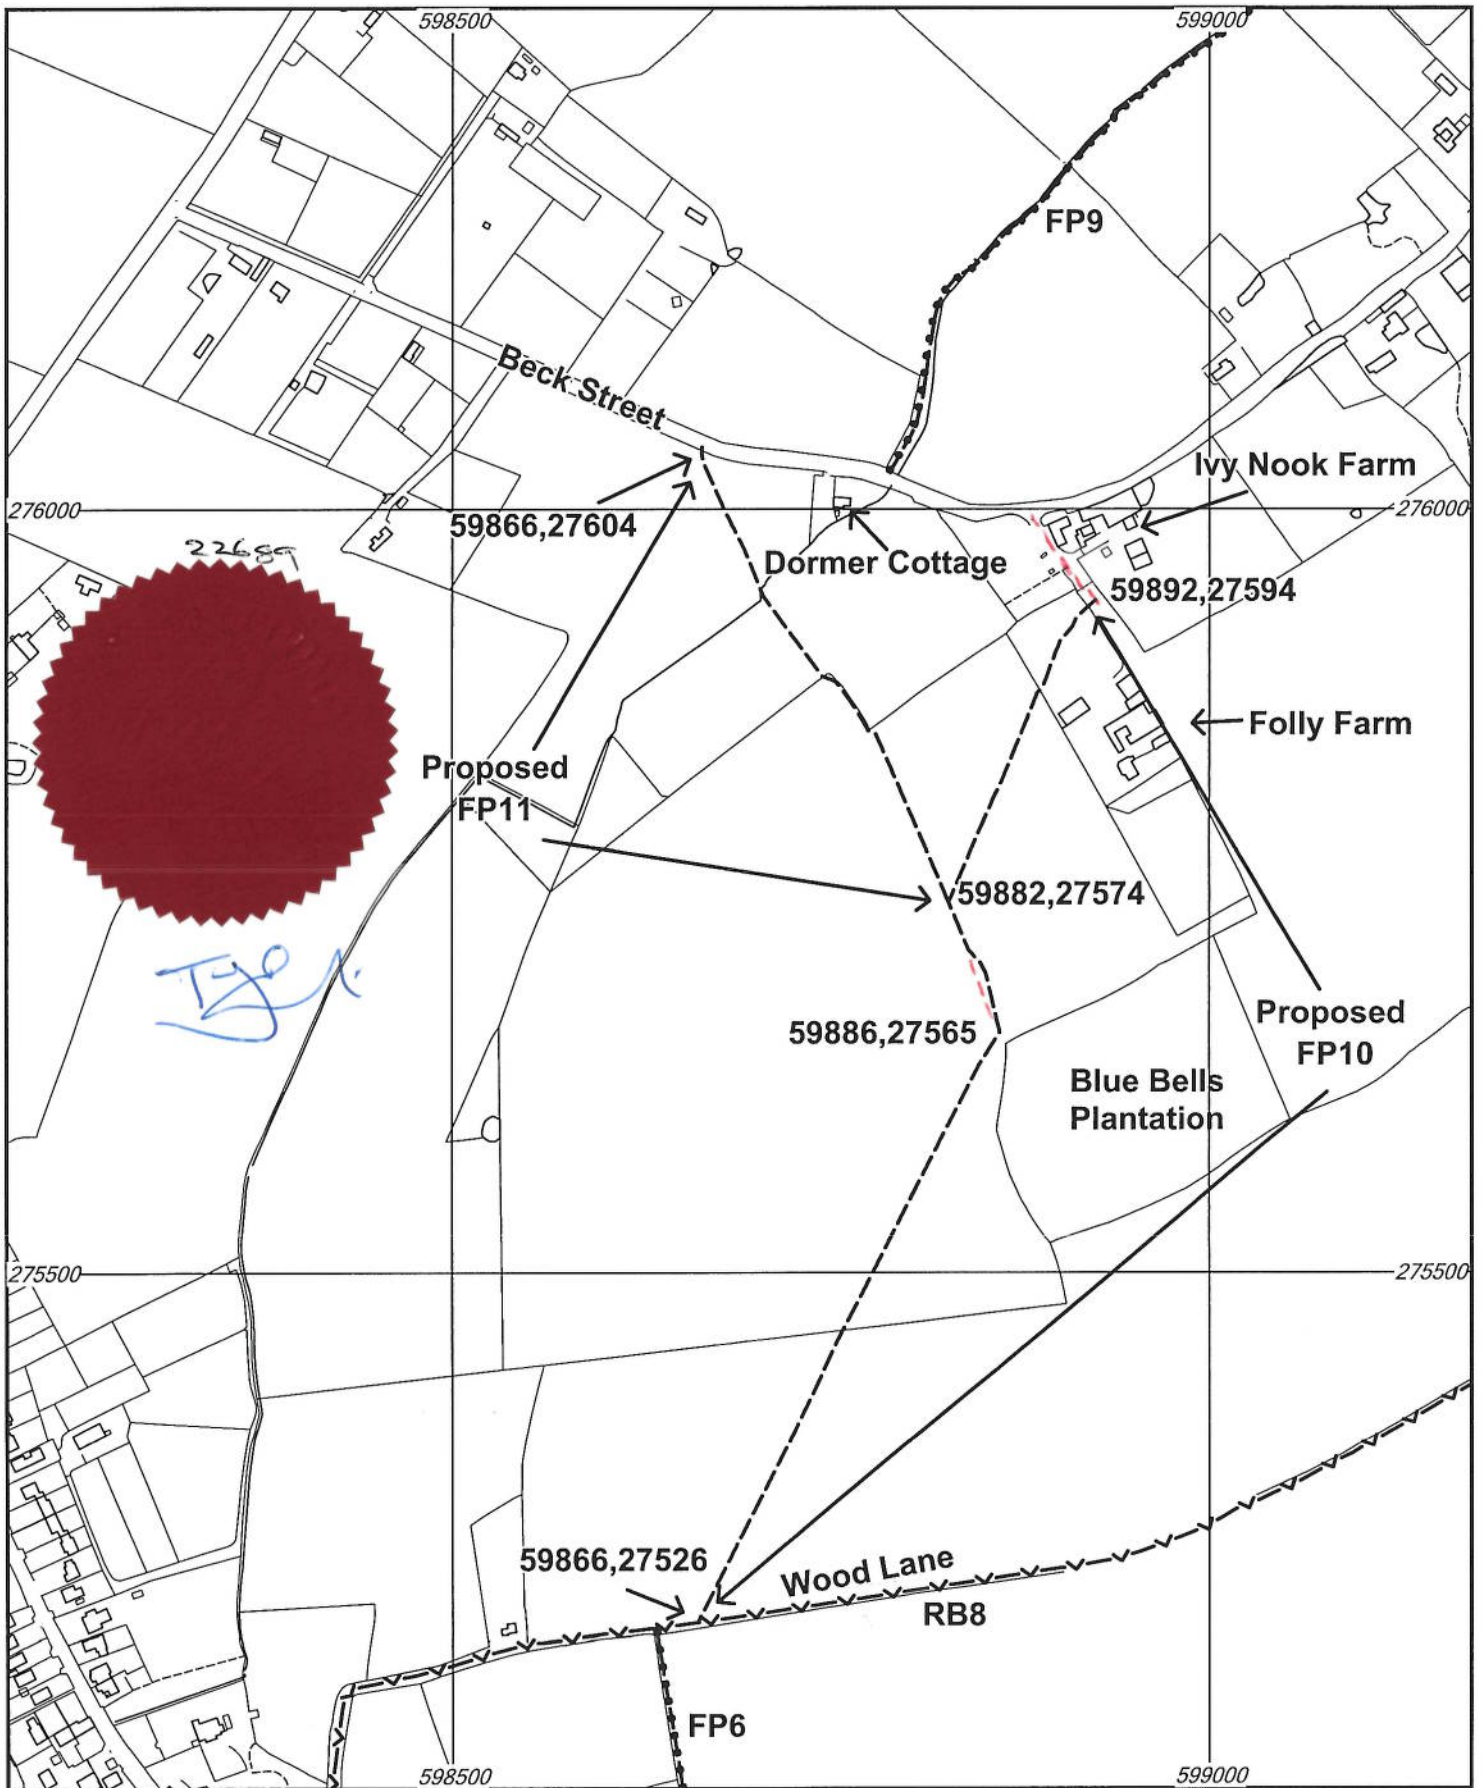

PROPOSED PUBLIC FOOTPATHS IN HEPWORTH



Director of Resource Management
 Endeavour House, 8 Russell Road, Ipswich, Suffolk. IP1 2BX

- Proposed Public Footpaths
- Existing Public Footpaths
- v-v-v- Restricted Byway

Scale 1:5000



Ordnance Survey MasterMap Crown Copyright. All rights reserved.
 Suffolk County Council Licence No. 100023395 2017

Filed at: